


Replaces the previously circulated one. Please note this does not change the context of the report.

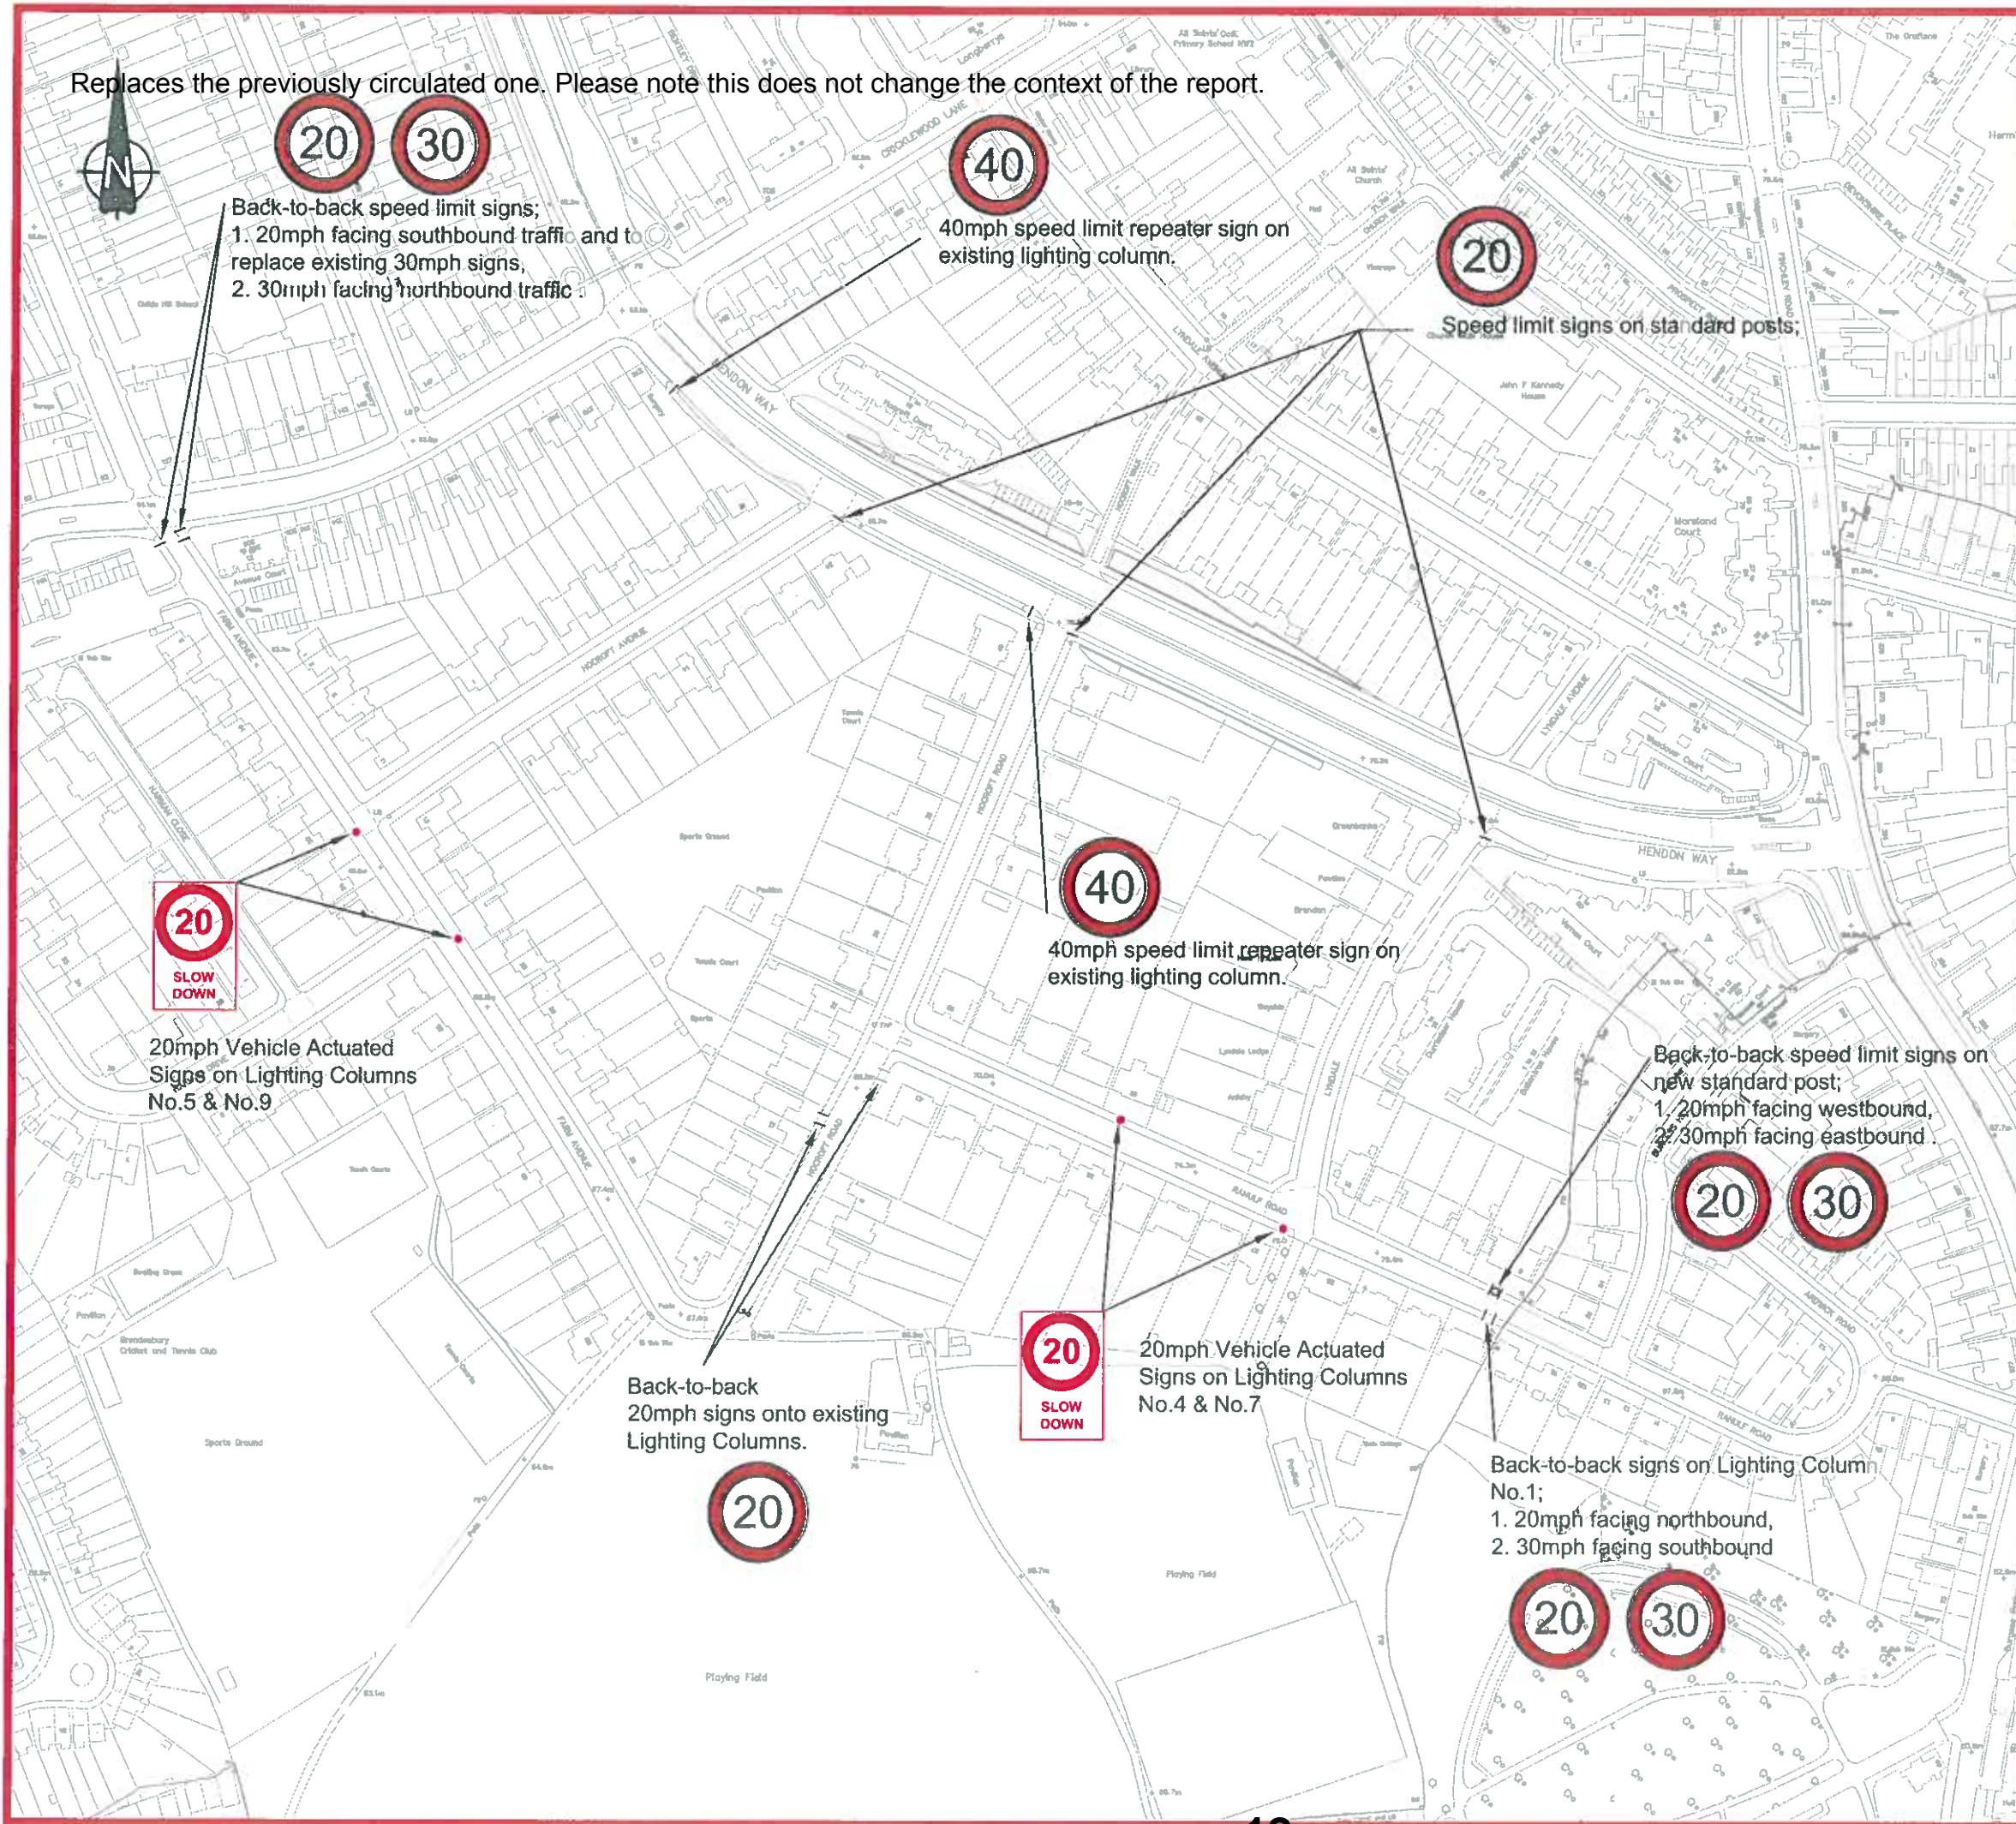

LEGEND:

- VAS '20 SLOW DOWN' onto existing or proposed Lighting Columns as per proposed street lighting design.
- Back to back speed limit signs on new posts or as otherwise specified.
- Speed limit signs as specified.

This product includes mapping data licensed from Ordnance Survey with the permission of the Controller of Her Majesty's Stationery Office. © Crown copyright and database right 2008. All rights reserved. London Borough of Barnet. Licence No. 100017674.

Revision and Date	Description	Initial

Pam Wharfe
Interim Director of Environment and Operations

North London Business Park
Oakleigh Road South
New Southgate N11 1NP
Tel. 020 8359 2000



SCHEME: HOCROFT ESTATE 20MPH SPEED LIMIT

TITLE: 20 MPH SPEED LIMIT 'AS BUILT' SIGN LOCATIONS

Scales: NTS	Date: 16/06/11
Initiated: NR	Drawn: TN
	Checked: NR

DRAWING NO: 60462C 'AS BUILT'

Acad Ref.